

A	Initial Issue	MBW	26/07/2022	
Rev.	Description	Drawn	Date	Checked

Surveyor:- RG  
Survey Date:- 22/07/2022  
Precal/Cad:- 08/06/2022




**BROOKLANDS PRIVATE ESTATE  
STAGE 2  
AS-CONSTRUCTED LOT LEVELS**

CLIENT:

## PROGRESS DEVELOPMENTS

The contents of this plan are current and correct as of the date stated within the revision panel. All consultants and persons wishing to utilise this data should satisfy themselves of this plans currency by contacting the McMullen Nolan Group.

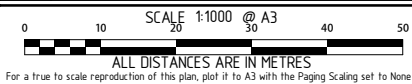

The boundaries shown on this plan were not re-established as part of this survey, therefore this plan does not guarantee their accuracy. Existing easements, encumbrance or interest are not depicted and a title search is recommended to obtain this information. Re-establishment of the cadastral boundaries is recommended for any proposed works on or near existing boundaries.



MCMULLEN NOLAN GROUP  
Level 1, 2 Sabre Crescent  
Jandakot, W.A. 6164  
PO Box 3526, Success  
W.A. 6964, Australia  
Offices in: Perth | Melbourne | Kimberley | South West WA

Tel: (08) 6436 1599  
Fax: (08) 6436 1500  
info@mngsurvey.com.au  
www.mngsurvey.com.au  
ABN 90 009 363 311

Project Mngnr.	MATT WEBB	Datum	PCG94 / AHD
<b>103096 - DE - 027 - A</b>			
Job	Type	Plan	Revision
Number		Number	